





**insight
design**

1900 N. Bayshore
Drive - #204-A
Miami, Florida
3 3 1 3 2
305.545.4964

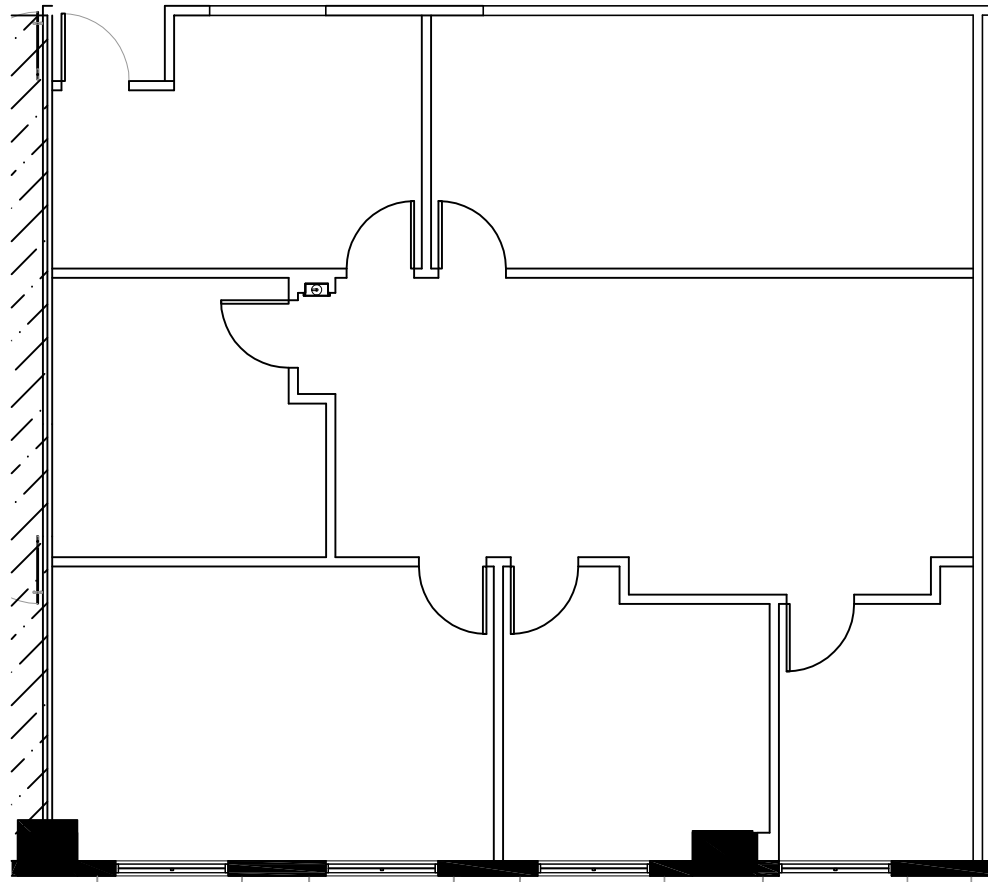

4000 Ponce de Leon
Suite 540 / As-Built Plan

5TH-FLOOR
N.T.S.

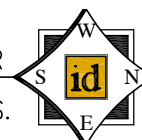

PROJECT NO:	1806-47
DRAWN BY:	I.M.
DATE:	02/24/26
SCALE:	N.T.S.
SHEET NO:	AS-1